


NOTES:

- LEGAL BASE MAP BASED ON M.D. OF ROCKY VIEW No.44 2008 LEGAL DRAWING.
- PIPELINE LOCATIONS ARE APPROXIMATE AND FOR INFORMATION ONLY. MPE ENGINEERING LTD., ROCKY VIEW WATER CO-OP LTD., AND THE M.D. OF ROCKY VIEW No.44 CANNOT ASSURE THE ACCURACY OF THIS RECORD DRAWING. THOSE RELYING ON THIS DRAWING ARE ADVISED TO OBTAIN INDEPENDENT VERIFICATION.
- LEGAL FABRIC IS NOT BASED UPON THE PROVINCE OF ALBERTA COORDINATE MAPPING SYSTEM. LEGAL LINES ARE APPROXIMATE ONLY AND ARE USED FOR ILLUSTRATIVE PURPOSES TO ASSIST IN DETERMINING LOCATIONS OF RVWC FACILITIES. NEITHER MPE ENGINEERING LTD., NOR THE ROCKY VIEW WATER CO-OP LTD., WILL BE HELD RESPONSIBLE FOR ANY INACCURACIES IN THE INFORMATION OR FOR ANY USE BY A THIRD-PARTY. DIMENSIONS AND LEGAL LINE WORK SHOULD NOT BE RELIED UPON AND SHOULD BE INDEPENDENTLY CONFIRMED FOR ACCURACY.
- ALL PIPE SERIES 160 PVC UNLESS NOTED OTHERWISE. PIPE DESIGNATED HDPE IS IPS SIZED. 40mm ROAD CROSSINGS TYPICALLY SERIES 160 HDPE IPS UNLESS NOTED OTHERWISE.
- ALL CURB STOPS LOCATED 1.0m OFF MAIN LINES UNLESS NOTED OTHERWISE.
- ALL MANUAL AIR RELEASES LOCATED ON EDGE OF R/W AND 1.0m OFF MAIN LINES UNLESS NOTED OTHERWISE.
- ALL FARM METER MANHOLES ARE 5 IGPM PVC MUELLER MANHOLES UNLESS NOTED OTHERWISE.

LEGEND

- TREATED WATER PIPELINE
- - - RAW WATER PIPELINE

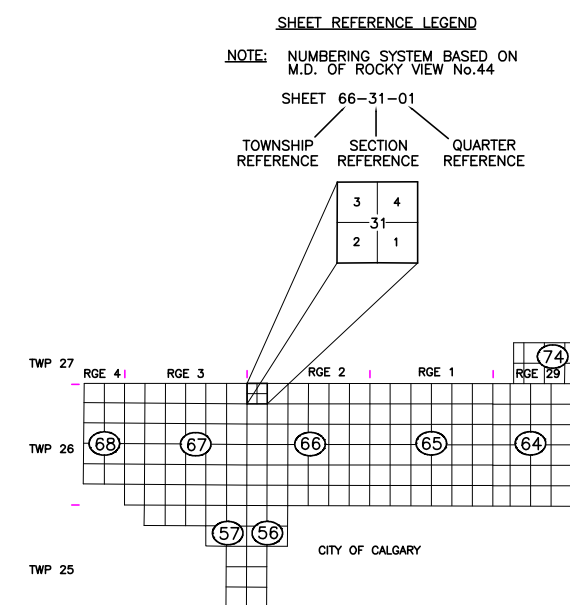

11	09-04-14	RECORD DRAWING
2-10	--	REVISIONS
1	94-05-01	RECORD DRAWING
ISSUE	DATE	REVISION

PERMIT TO PRACTICE
MPE ENGINEERING LTD.
 PERMIT NUMBER: P 3680
 The Association of Professional Engineers,
 Geologists and Geophysicists of Alberta

ORIGINAL
 SEALED BY
**RANDALL J.
 BORAS**
 08-07-23



ROCKY VIEW WATER CO-OP LTD.

TREATED WATER
 DISTRIBUTION SYSTEM
 SITE PLAN

DESIGNED	R.B.	CHECKED	D.L.P.
DRAWN	R.G., J.B., J.W.	JOB	2080-004-02
SCALE	1:100 000	SHEET	
DATE	APRIL, 1994	DRAWING	